



WINGCHESTER'S RESTAURANT
717 TAUGHENBAUGH BLVD.
RIFLE, COLORADO

ISSUE:
PROGRESS: 05-26-17
BLDG PERMIT: 08-09-17
REVISED PERMIT: 03-30-18
AS-BUILT: 11-02-18

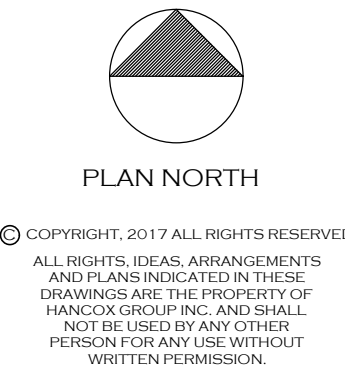


EXISTING AND PROPOSED FLOOR PLANS

SHEET NO. A3.1
SCALE: 3/16" = 1'-0"

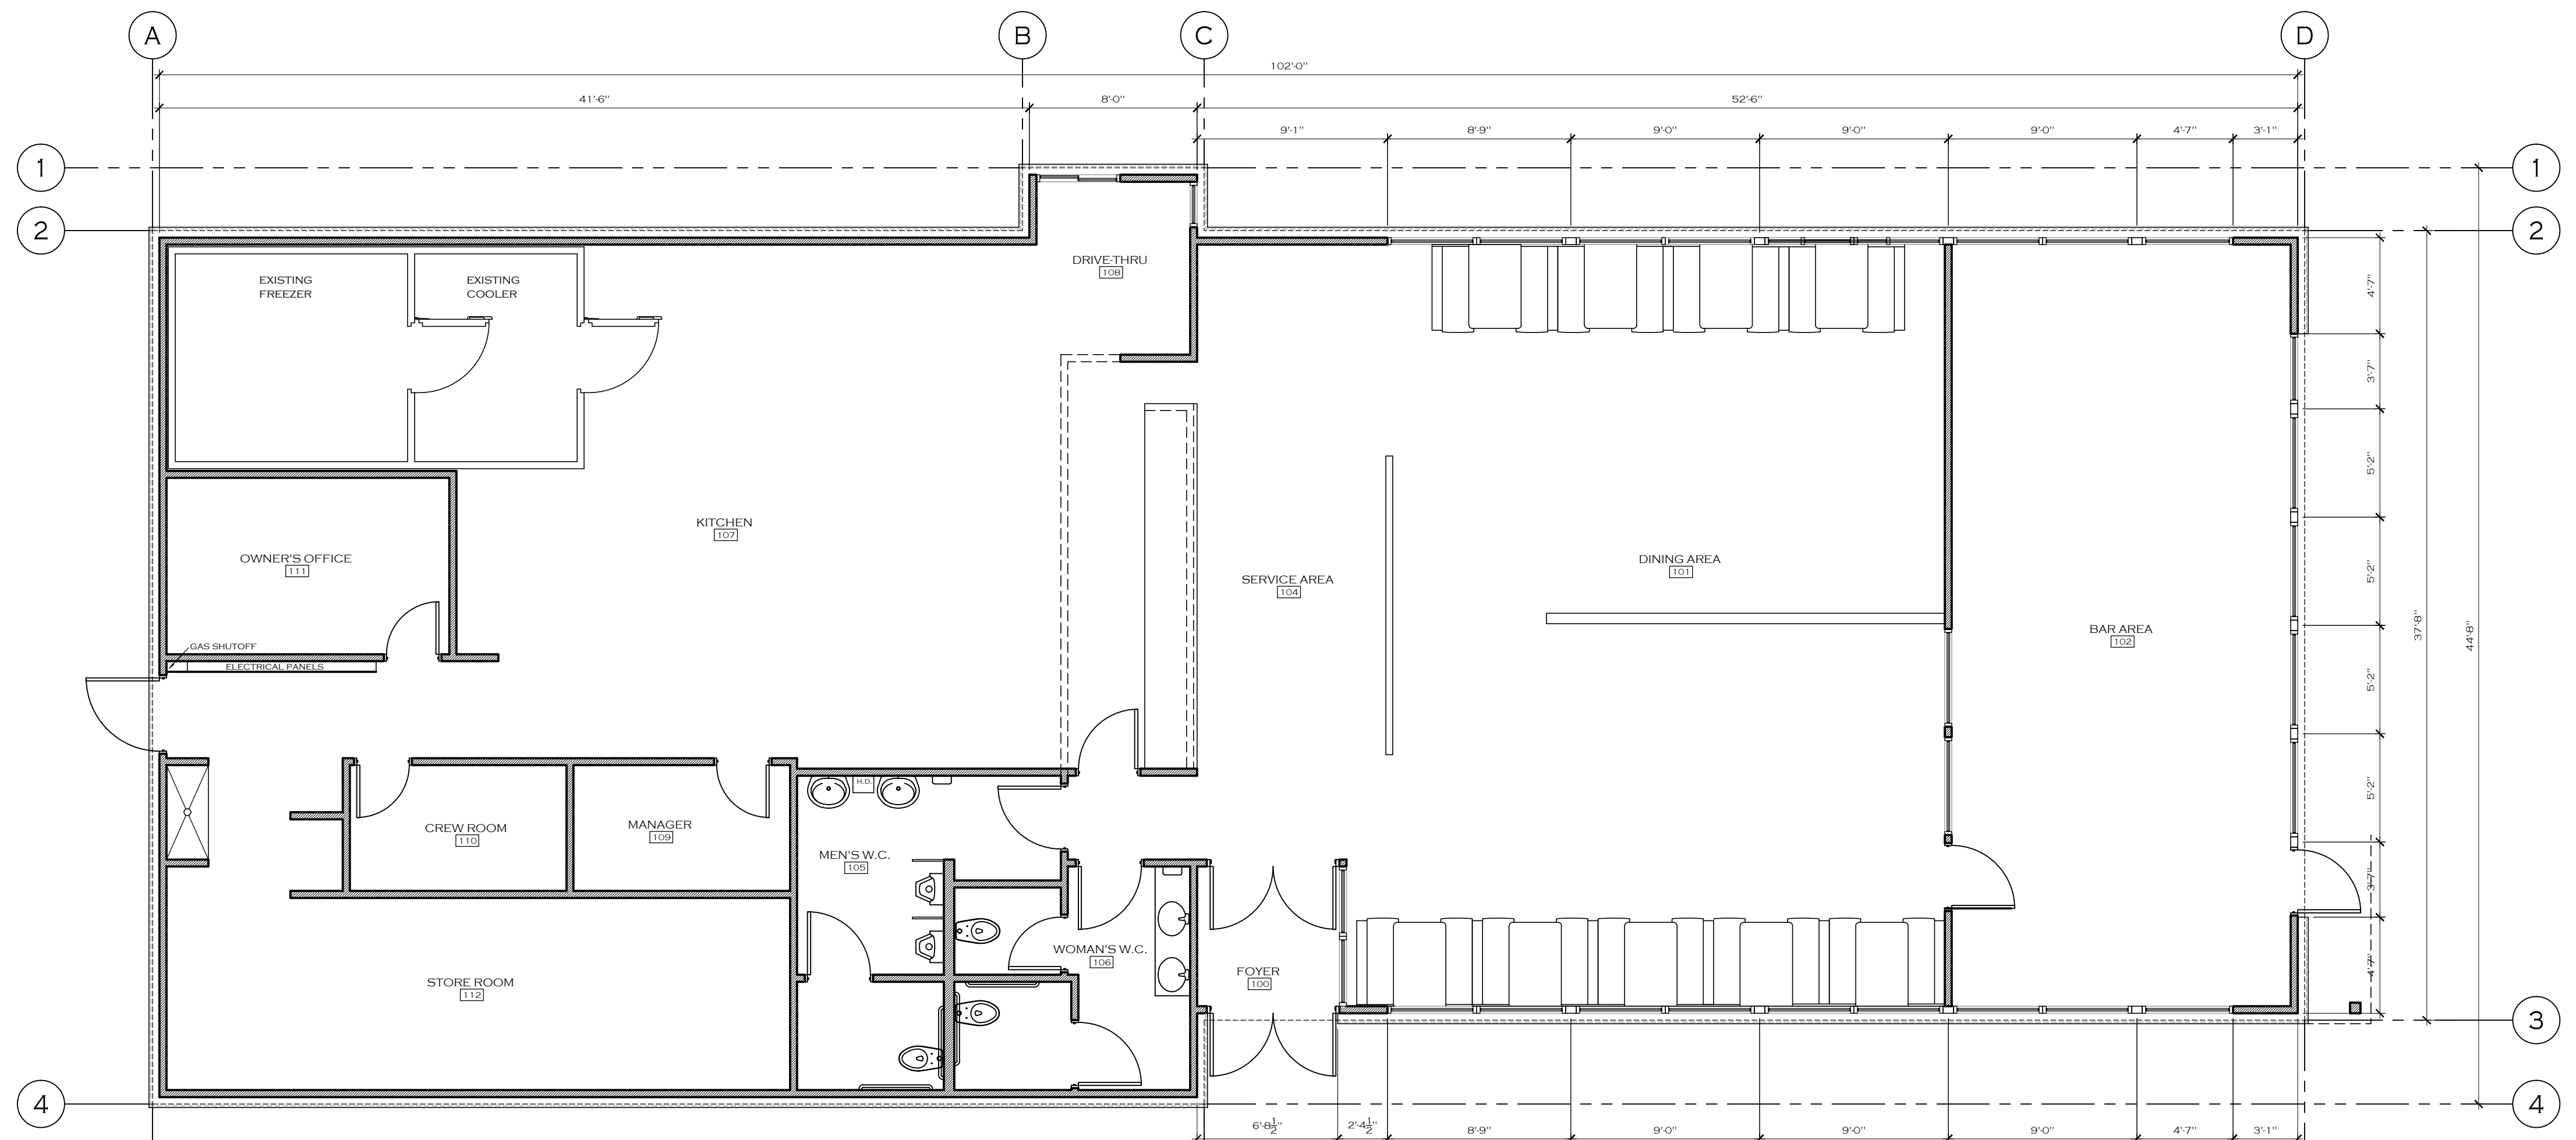

EXISTING FLOOR PLAN

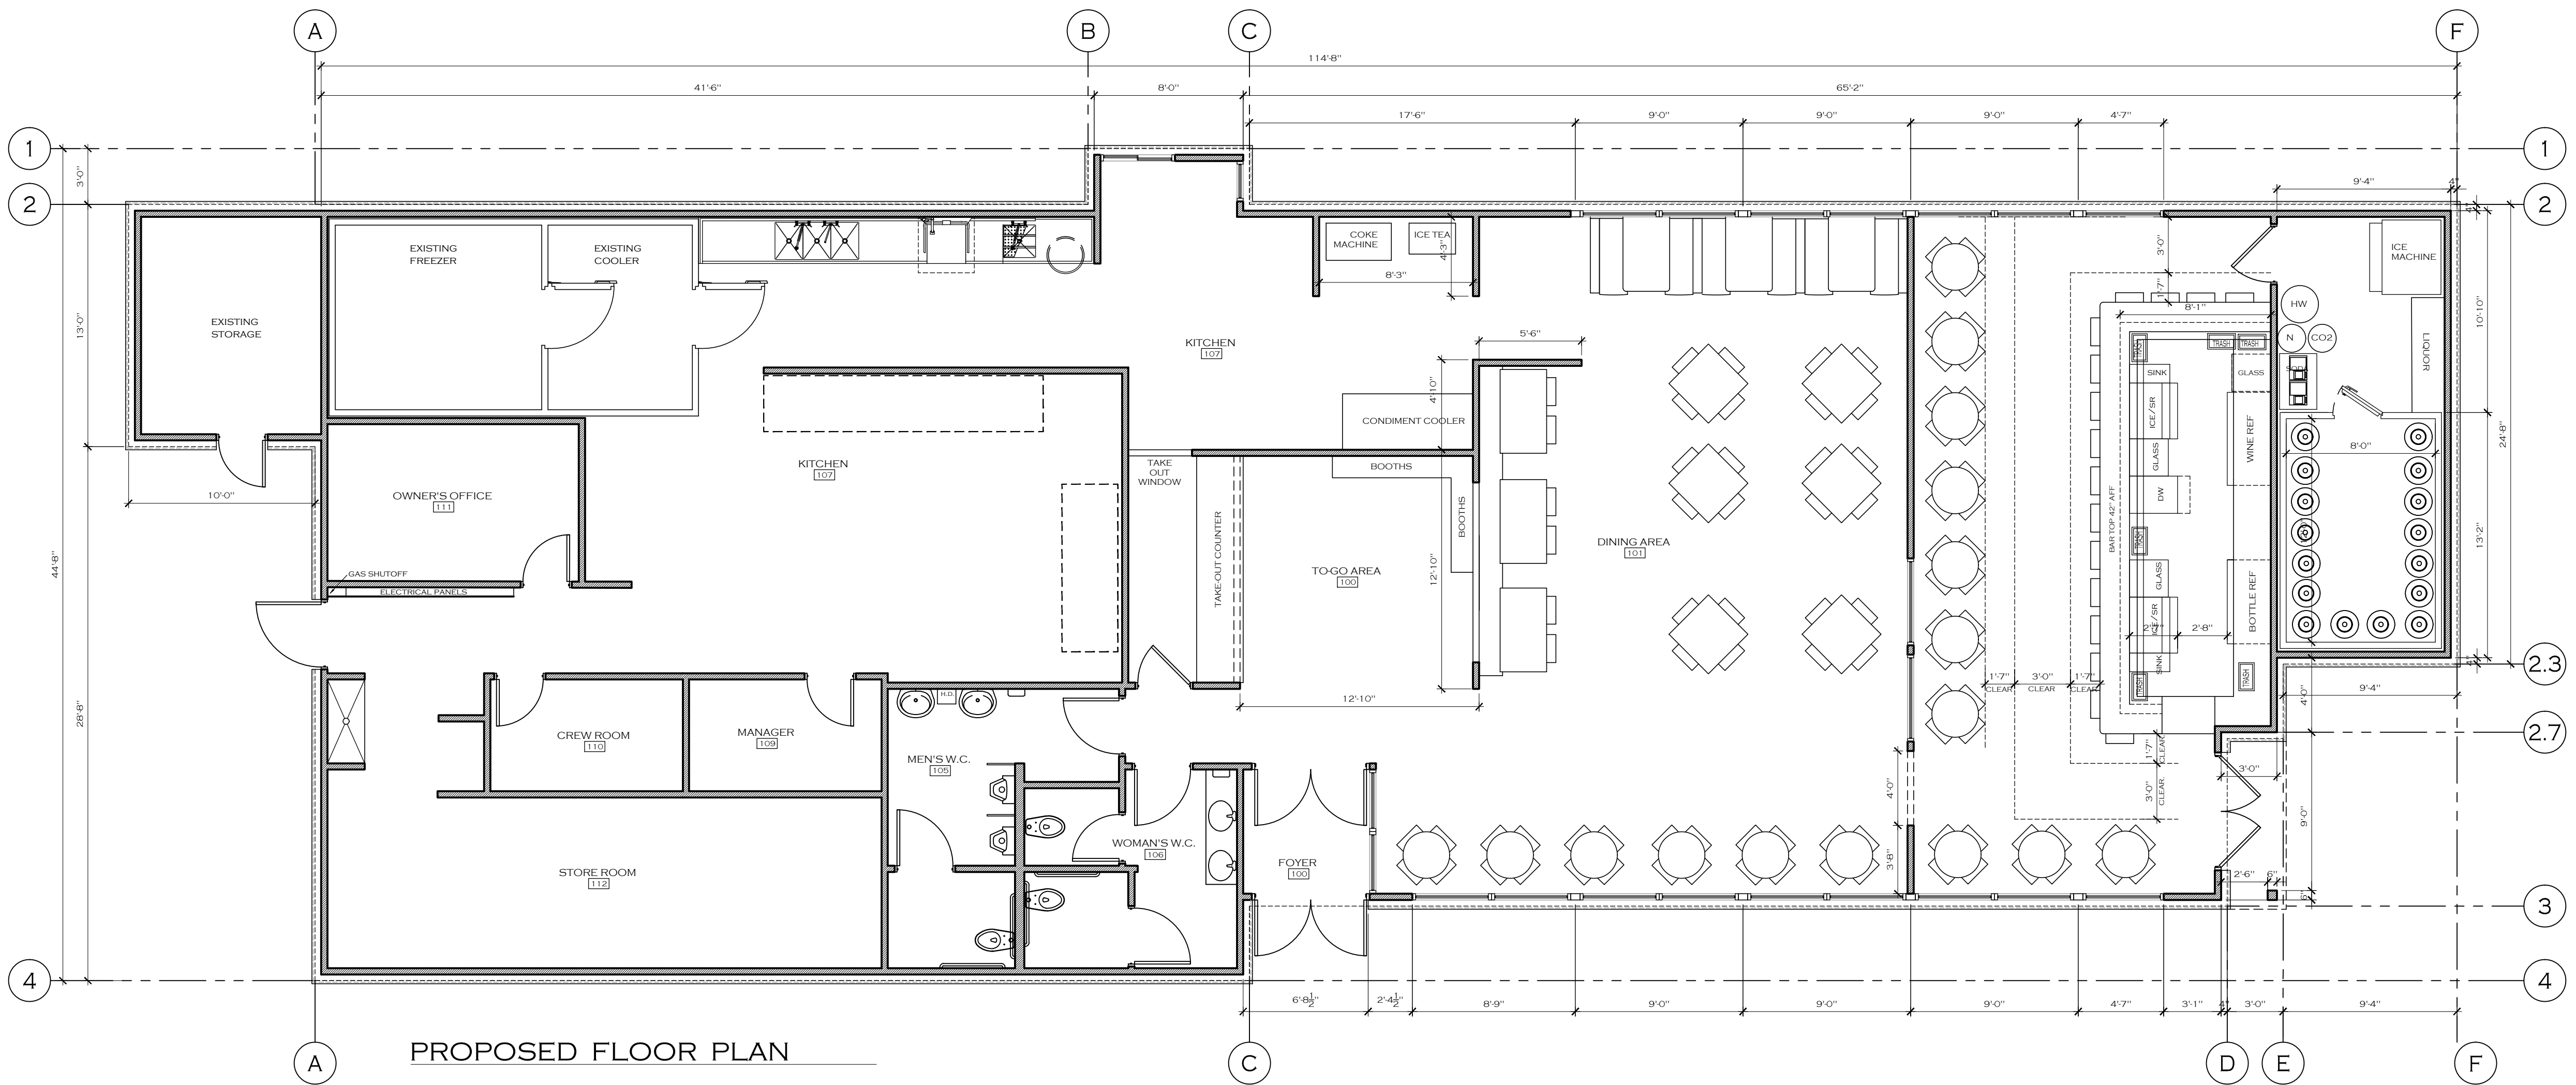

PROPOSED FLOOR PLAN